


007
C

007
C

B
006

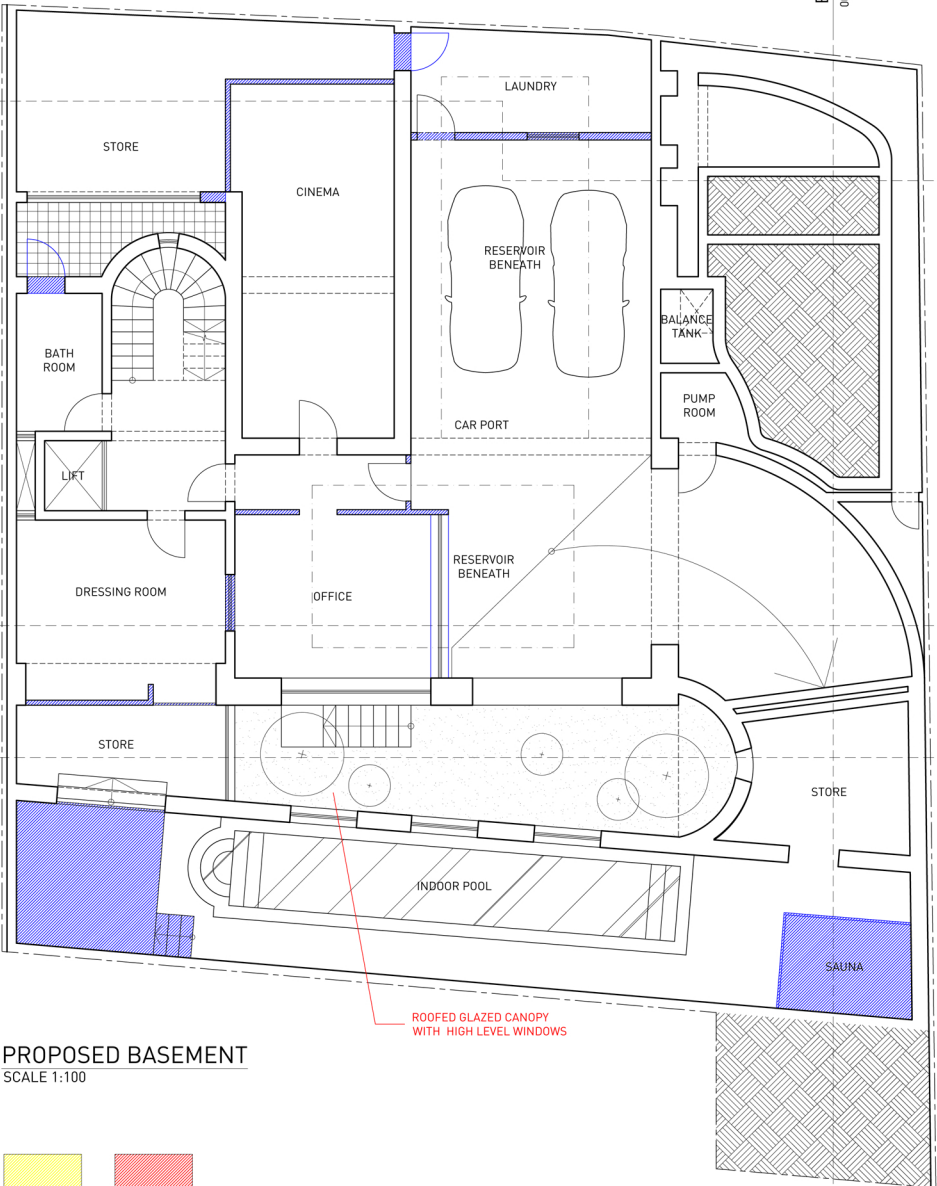

E
008

E
008

A
005

A
005

B
006

PROPOSED BASEMENT
SCALE 1:100

- DEMOLISH
- BUILD
- AS CONSTRUCTED
- AS APPROVED BUT NOT BUILT