



As Approved Levels 4 & 5 (Scale 1:100)


Correct site configuration following
more accurate survey

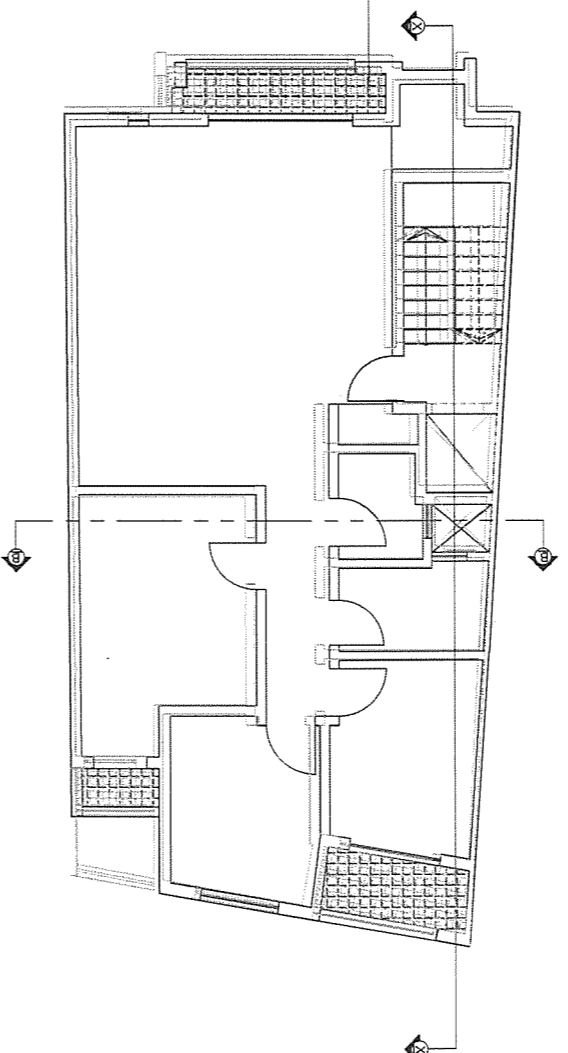

Levels 4 & 5 - as built (Scale 1:100)

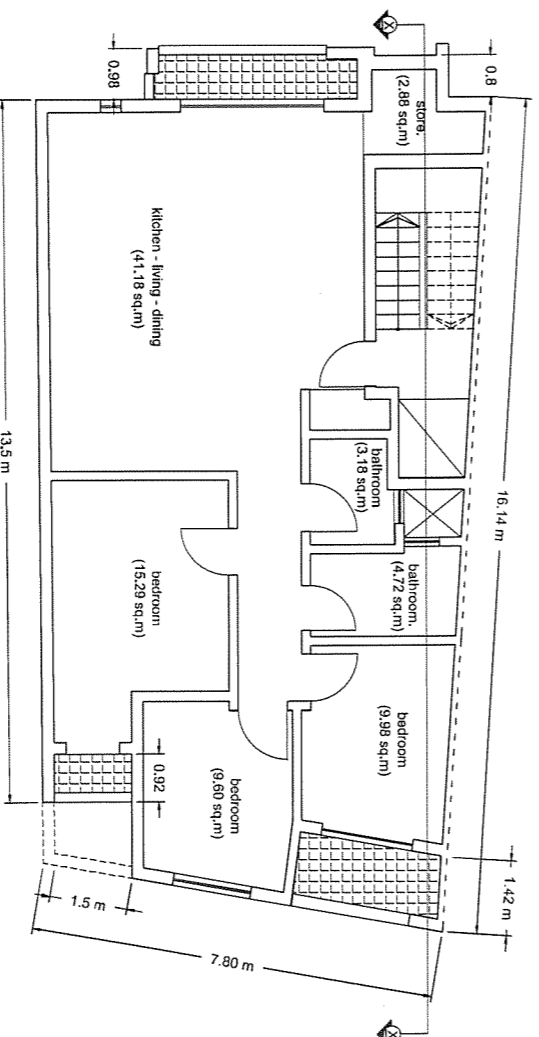

SCALE BARS:

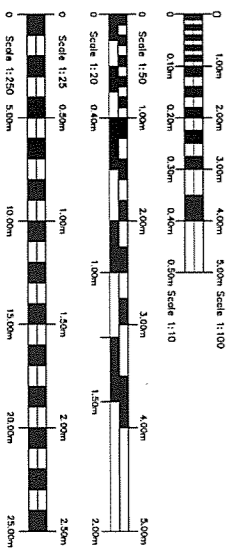

DRAWING TITLE		DRAWING REF.	
Levels 4 & 5 - Layout Plans			
ARCHITECT	DRAWN BY	SCALE	DATE
		1:100	