



9a

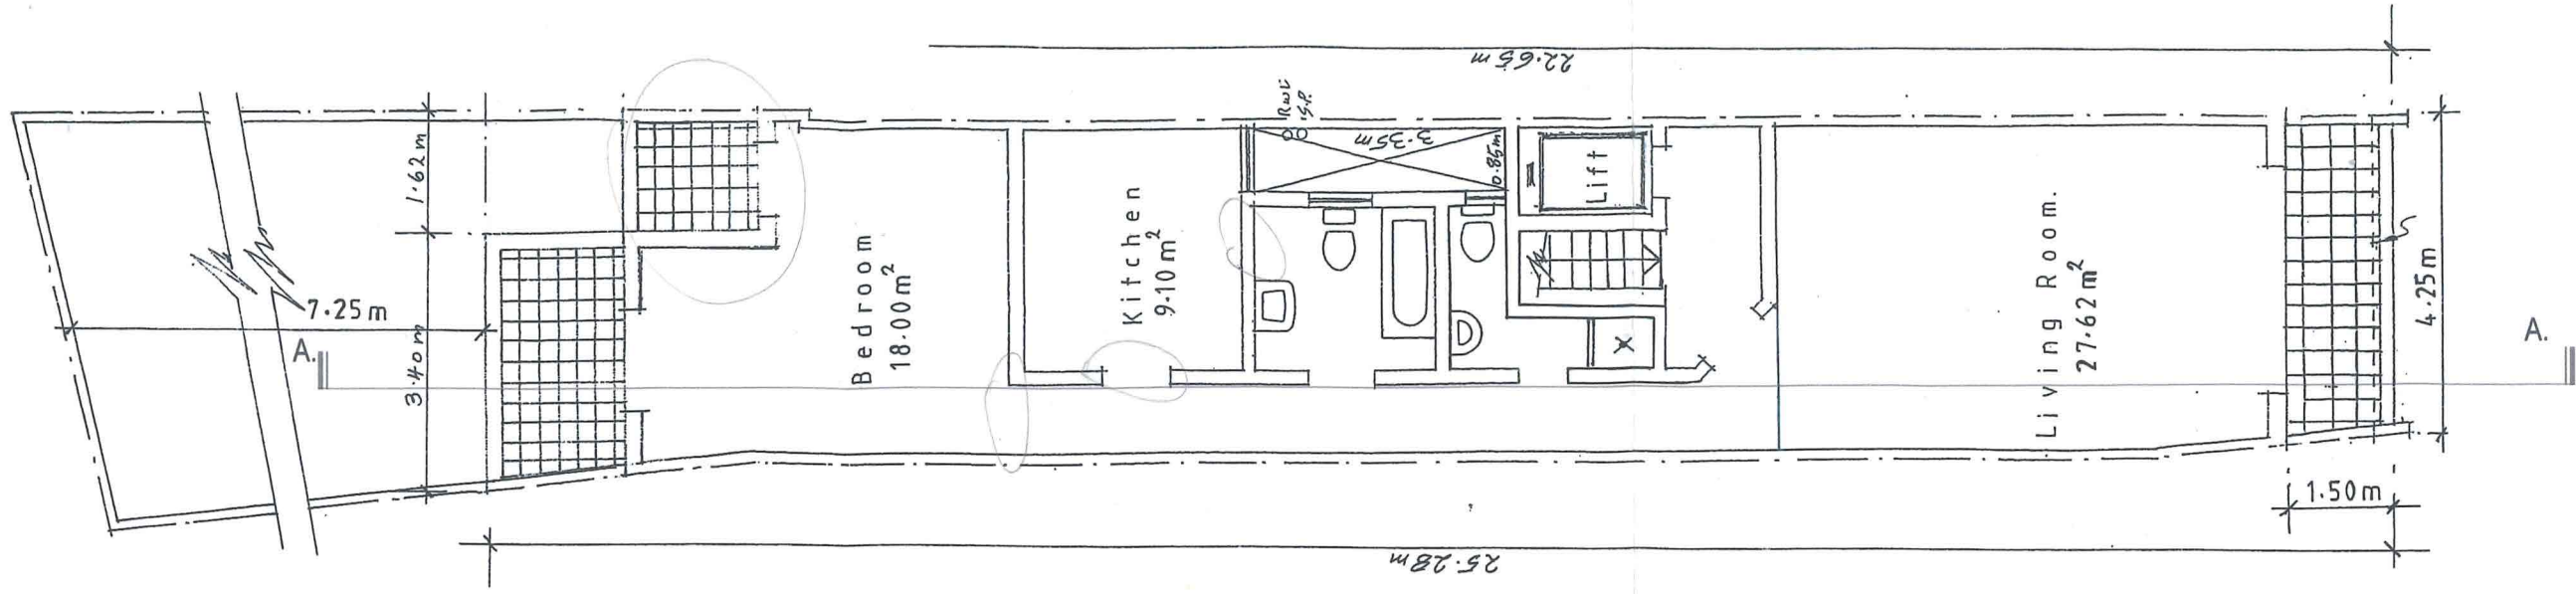


Penthouse  
As Built

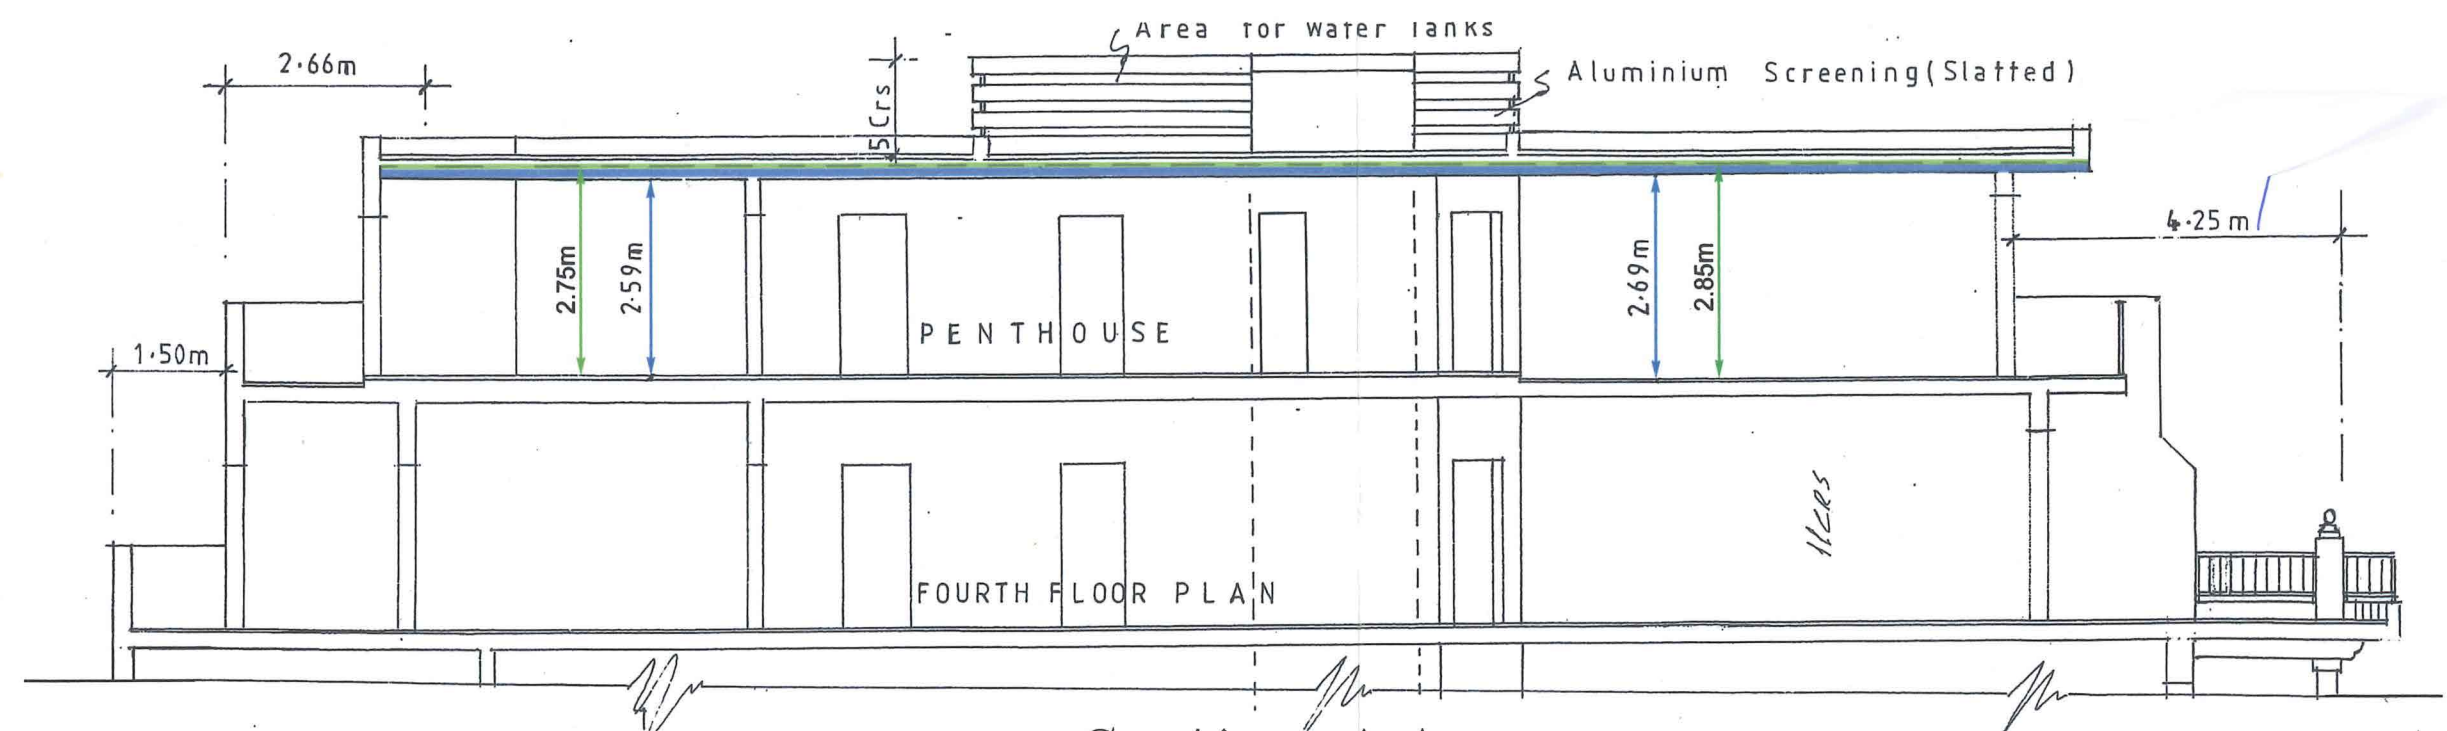

Section A.A.  
As Built

- Blue As Constructed
- Green As Approved but Not Constructed

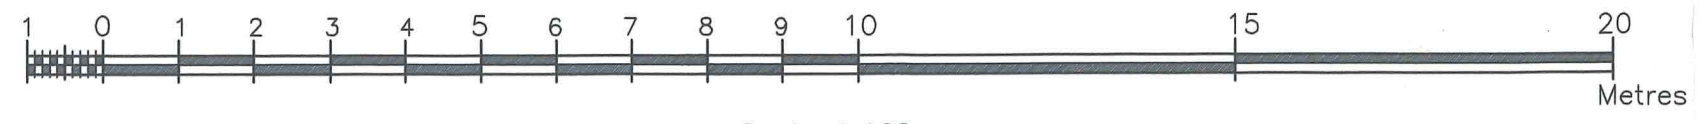

Scale 1:100