


SCALE 1:100

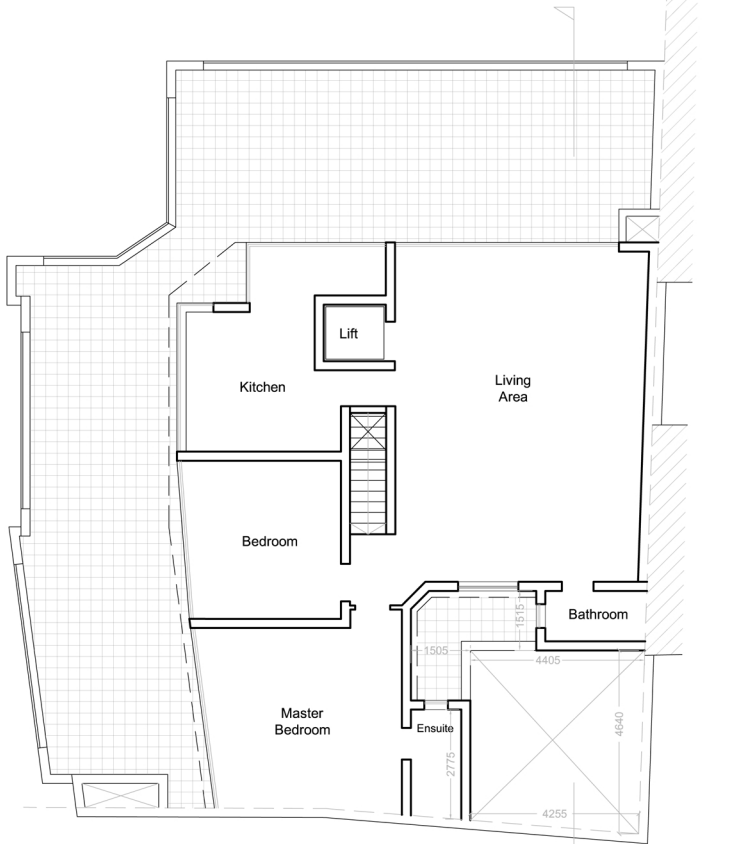

As Built Plans
Scale 1:100