





AS APPROVED

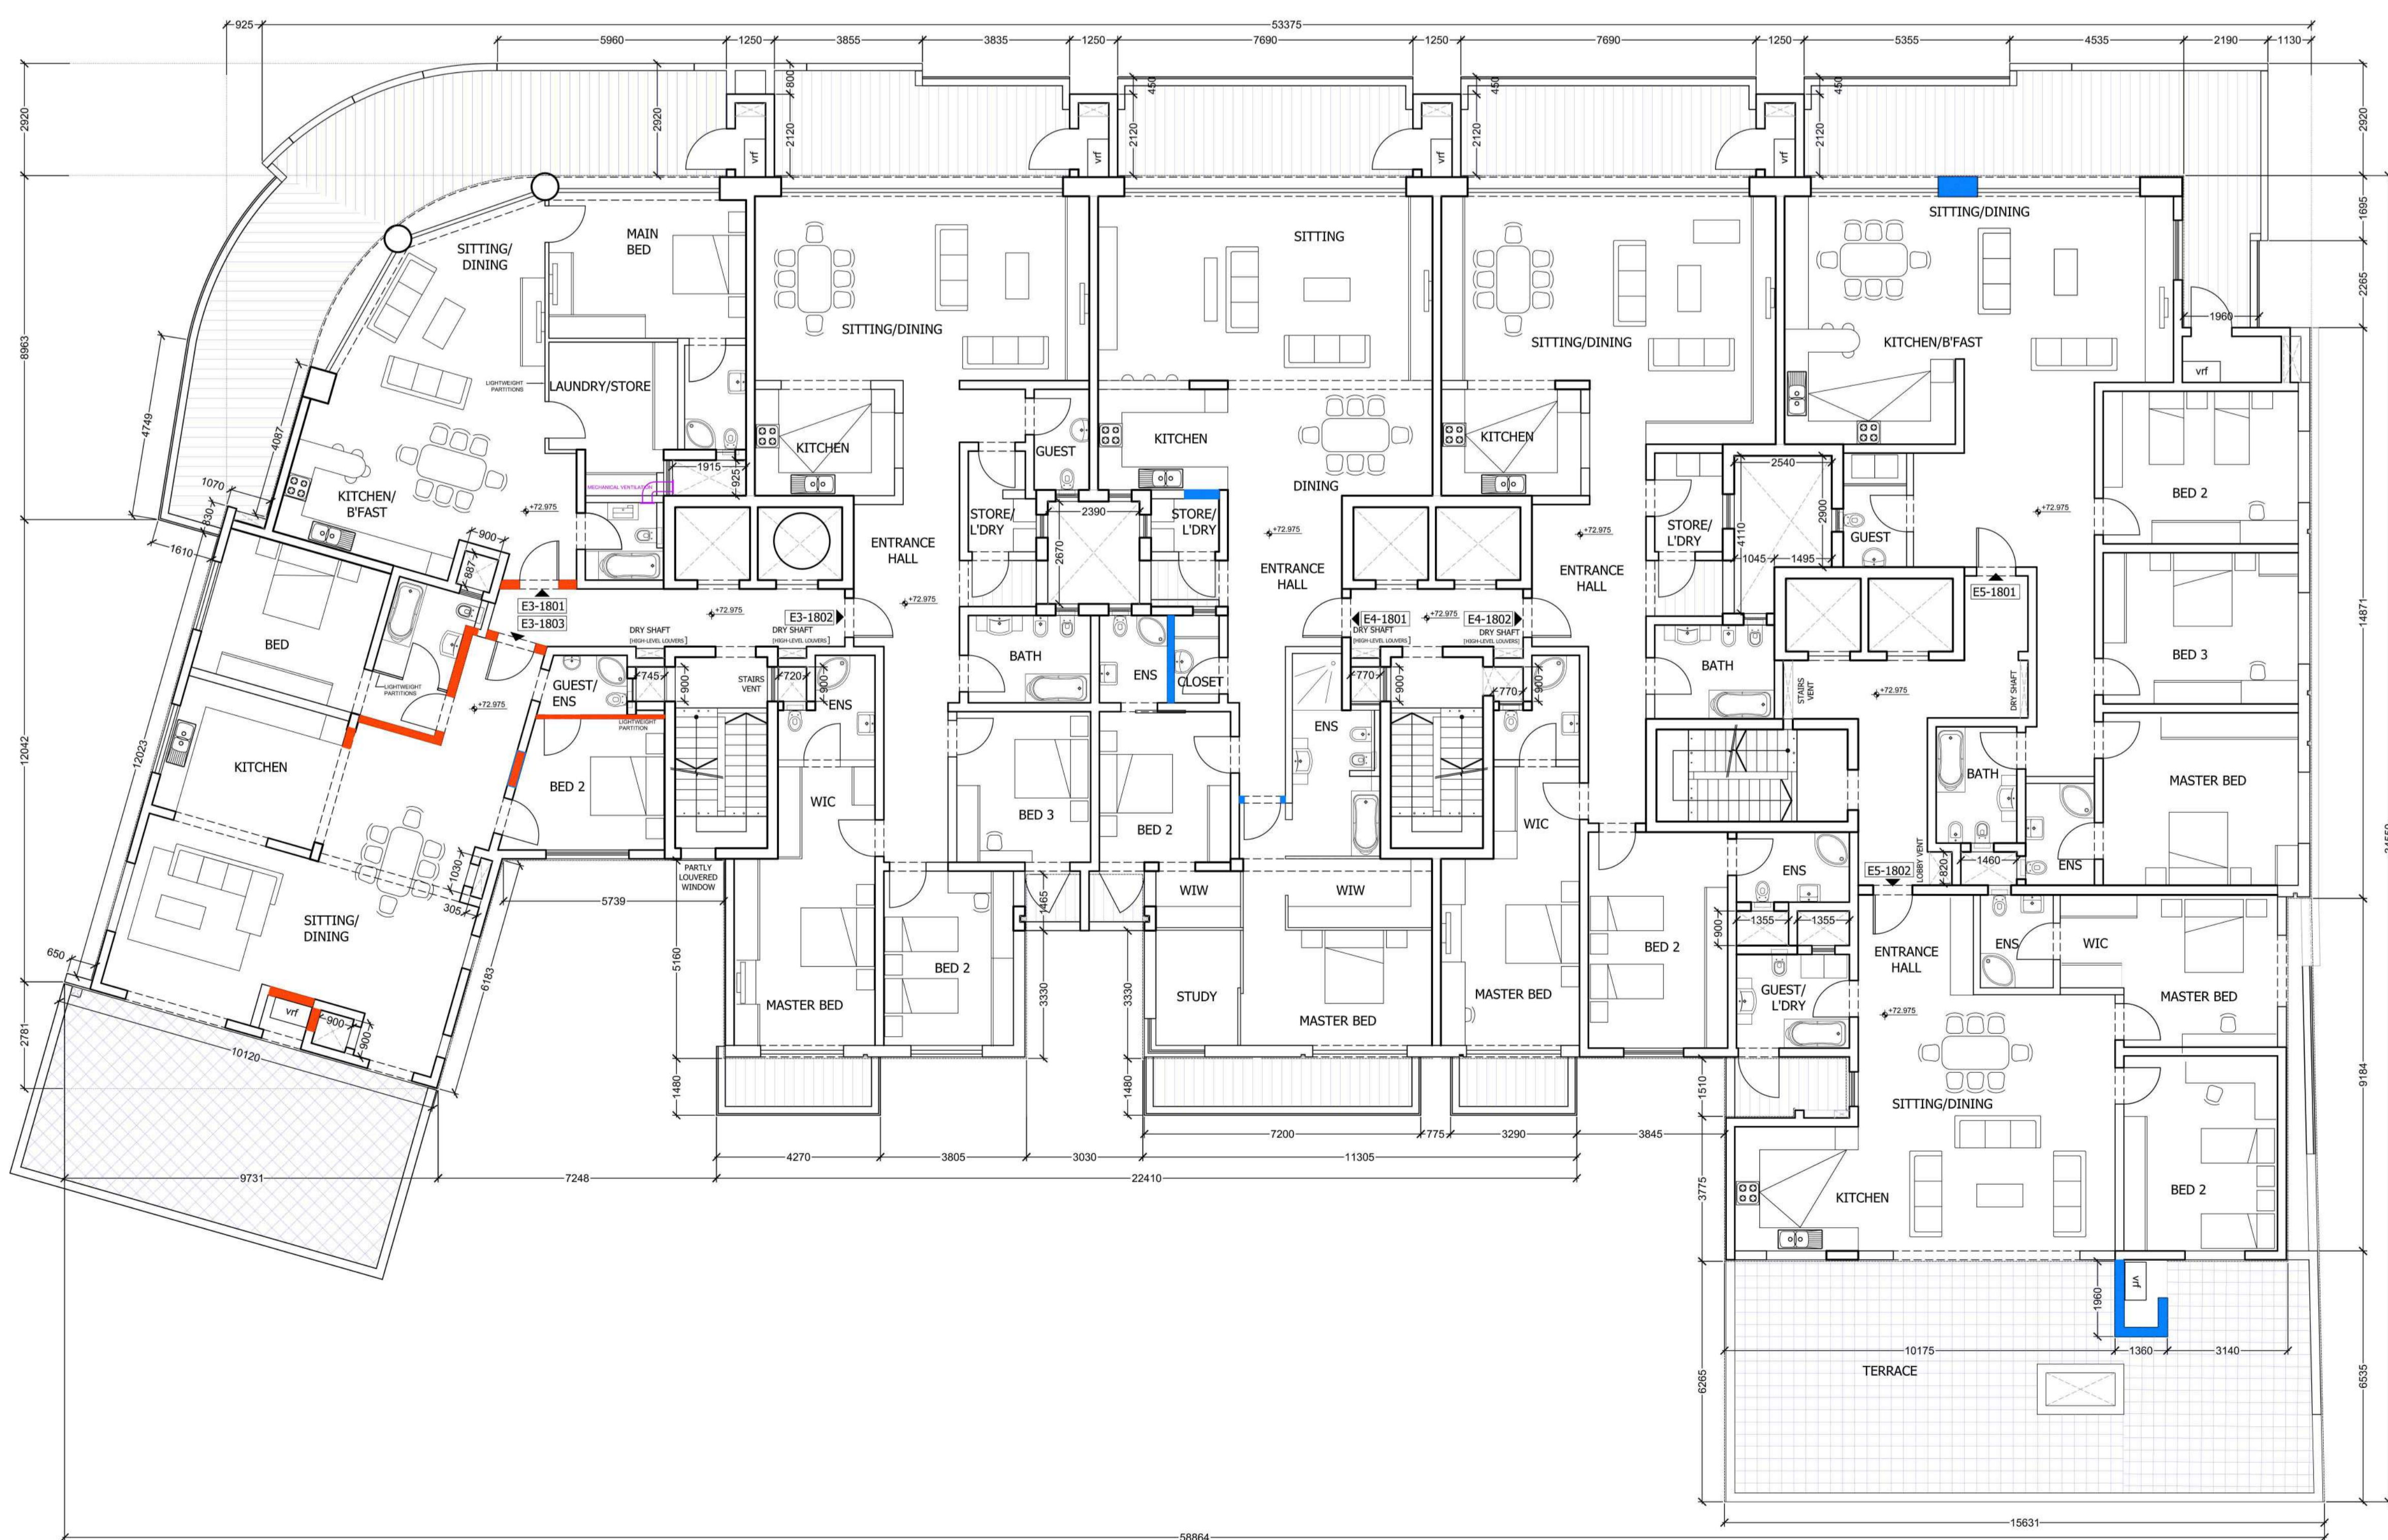

AS BUILT

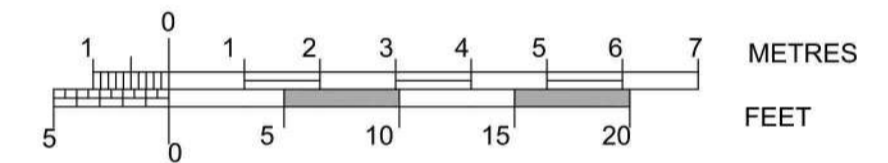